


3/20/2023 12:57 PM \\PNDSEAFS01\Drawings\2022\224017 Depoe Bay Floats 2-4 Replacement\ISSUED FOR BID\224017.S1.01.dwg

SLIP COUNT (PROPOSED)		EXISTING SLIP COUNTS
SLIP LENGTH	QUANTITY	
25'	14	66 SLIPS 25' TO 35' LONG 65 SLIPS
32'	42	
35'	10	
45'	9	17 SLIPS > 35' LONG 19 SLIPS
55'	8	
TOTAL	83	84

ESTABLISH BASIS OF BEARING
CONTROL PT. #1: FACE OF TOP OF BULKHEAD AT CENTERLINE OF GANGWAY (EXISTING DOCK 1)
CONTROL PT. #2: CENTERLINE AT END OF EXISTING DOCK 1
LAYOUT DOCKS 2, 3 AND 4
CONTROL PT. #3: FACE OF TOP OF BULKHEAD ON MEASURED LINE PERPENDICULAR TO BASIS OF BEARING, DISTANCE FROM CONTROL PT. #1 MARKS CENTERLINE OF NEW DOCK 2
CONTROL PT. #4: CENTERLINE ON NEW DOCK 2

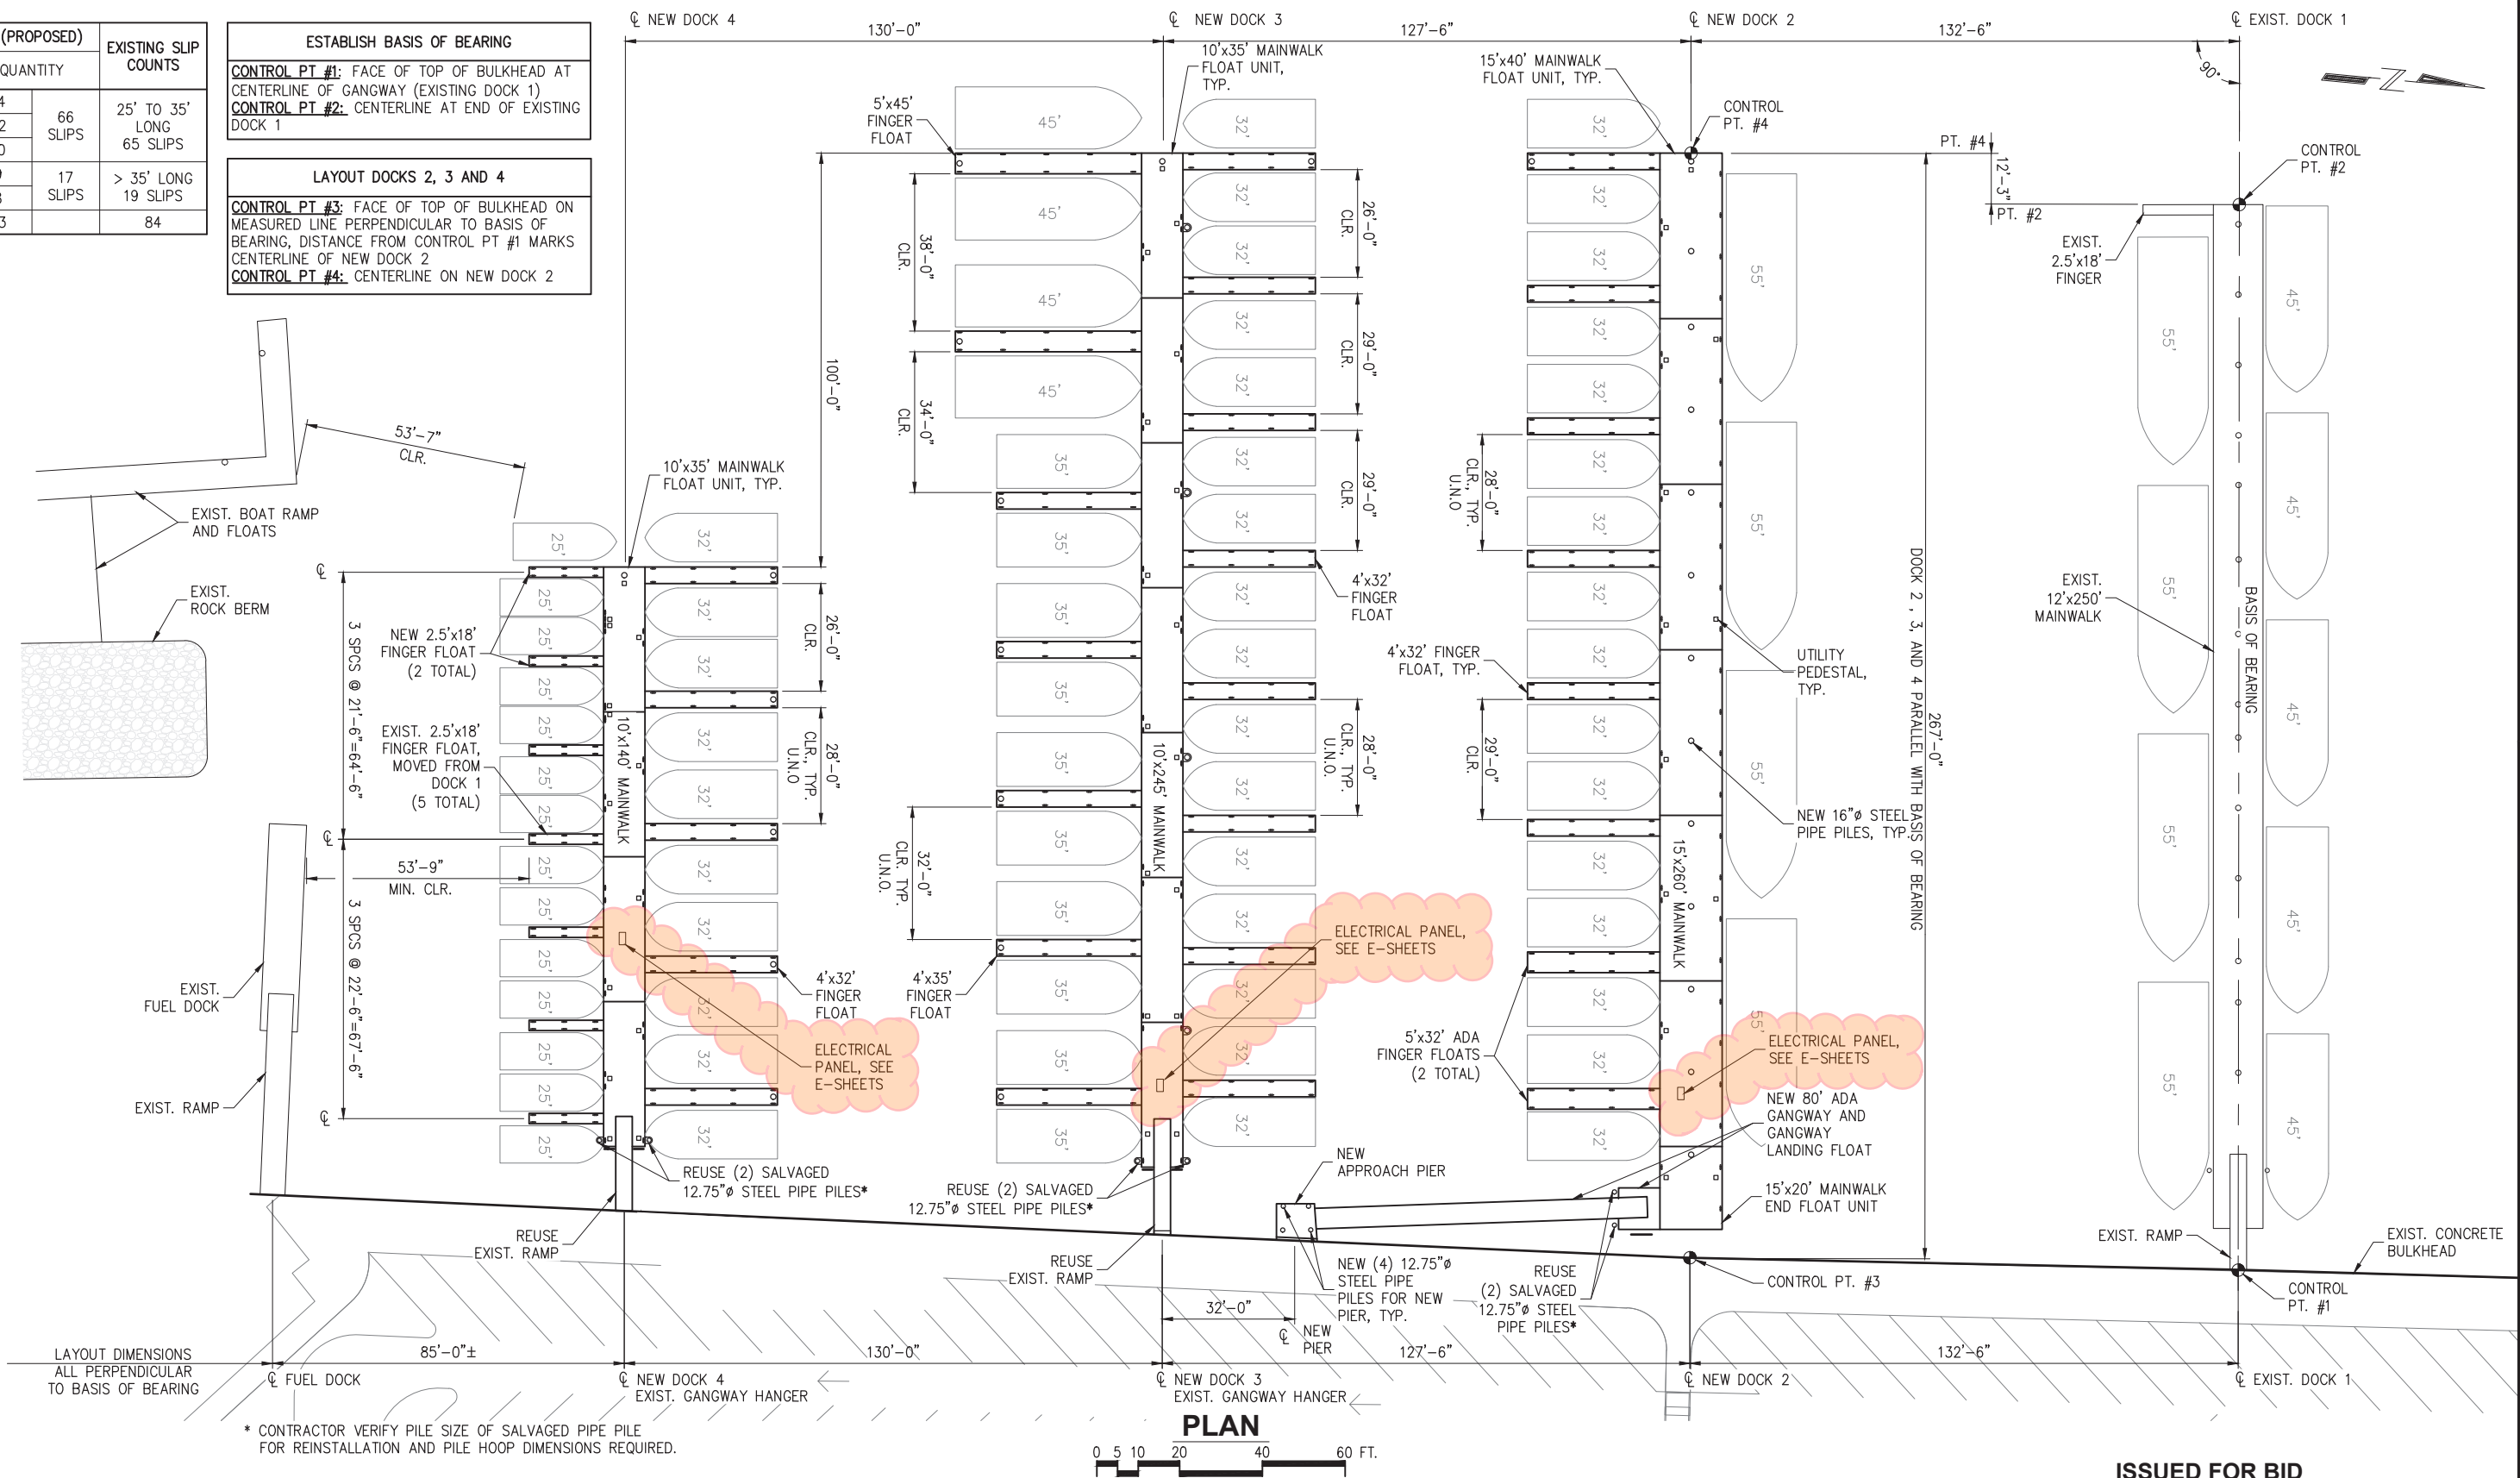

\* CONTRACTOR VERIFY PILE SIZE OF SALVAGED PIPE PILE FOR REINSTALLATION AND PILE HOOP DIMENSIONS REQUIRED.



3240 Eastlake Avenue E.  
Seattle, Washington 98102  
P: 206.624.1387  
www.pndengineers.com

PND ENGINEERS, INC. IS NOT RESPONSIBLE FOR SAFETY PROGRAMS, METHODS OR PROCEDURES OF OPERATION, OR THE CONSTRUCTION OF THE DESIGN SHOWN ON THESE DRAWINGS. WHERE SPECIFICATIONS ARE GENERAL OR NOT CALLED OUT, THE SPECIFICATIONS SHALL CONFORM TO STANDARDS OF INDUSTRY. DRAWINGS ARE FOR USE ON THIS PROJECT ONLY AND ARE NOT INTENDED FOR REUSE WITHOUT WRITTEN APPROVAL FROM PND. DRAWINGS ARE ALSO NOT TO BE USED IN ANY MANNER THAT WOULD CONSTITUTE A DETRIMENT DIRECTLY OR INDIRECTLY TO PND.

REVISIONS		
REV	DATE	DESCRIPTION

PROJECT: <b>DEPOE BAY HARBOR DOCKS 2-4 REPLACEMENT</b>			
TITLE: <b>PROPOSED NEW DOCK LAYOUT</b>			
DESIGNED BY: JO	PROJECT NO: 224017	SHEET NO: <b>S1.01</b>	
DRAWN BY: WL	DATE: MAR 2023		
CHECKED BY: RJ	SCALE: NOTED		